


**3100 Cumberland Blvd SE  
Cumberland Center II-Cumberland Center**



Not to Scale

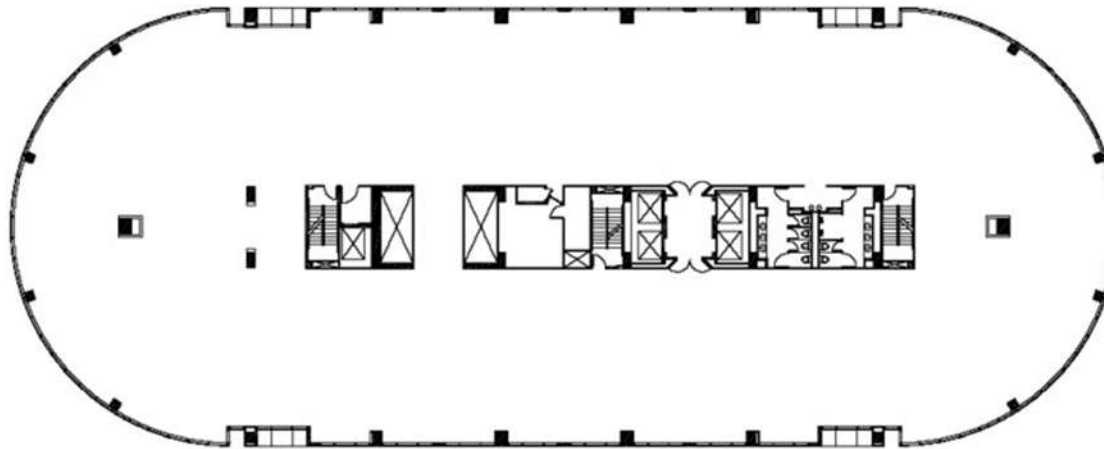

3100 Cumberland Boulevard  
Atlanta, Georgia 30339  
Jeff Bellamy 404.995.2221



**Cumberland Center II • Fourth Floor • 24,750 RSF**

**As Built**

11.01.07

**4th Floor, 24,750 SF**