



**3100 Cumberland Blvd SE
Cumberland Center II-Cumberland Center**

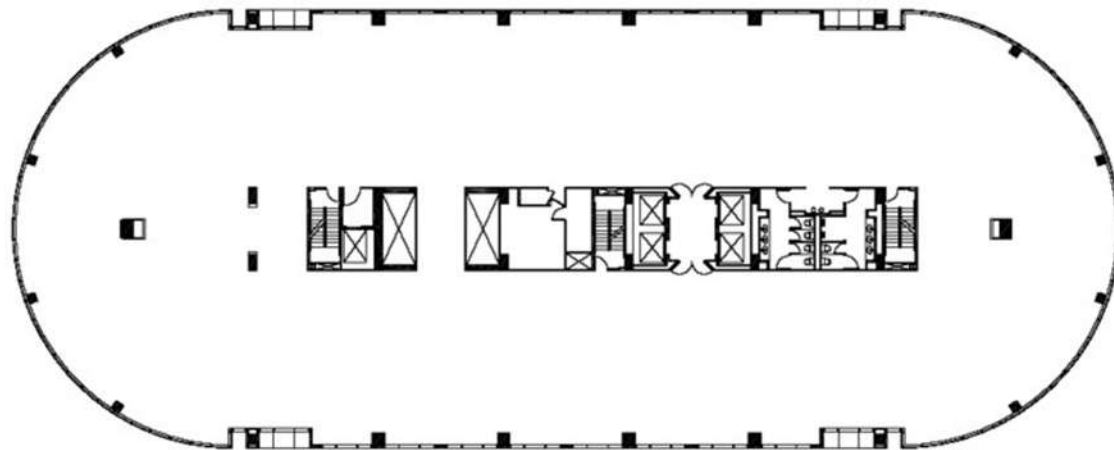

Not to Scale

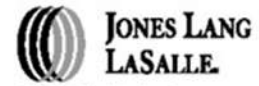

3100 Cumberland Boulevard
Atlanta, Georgia 30339
Jeff Bellamy 404.995.2221



Cumberland Center II • Fifth Floor • 24,750 RSF

As Built

5th Floor, 24,750 SF